




- THE CONTRACTOR SHALL VERIFY ALL DIMENSIONS ON SITE.
- DO NOT SCALE DIMENSIONS OFF DRAWINGS.
- ALL PLANS ARE TO BE READ IN CONJUNCTION WITH THE SPECIFICATION.
- COPYRIGHT OF THIS DRAWING BELONGS TO INSIDE DESIGN LTD.
- CONTRACTOR TO CHECK ALL BOUNDARY HEIGHT PLANES AND LEVELS ON SITE & NOTIFY THE CLIENT OR DESIGNER IMMEDIATELY IF THESE PLANES WILL BE BREACHED PRIOR TO CONSTRUCTION.
- ALL WORK IS TO COMPLY WITH THE NZBC, NZS 3804 AND LOCAL TERRITORIAL AUTHORITY REGULATIONS.

STATUS CODES:
SK=Sketch, CD=Concept Design, DD=Developed Design, RC=Resource Consent, BC=Building Consent, CA=Construction Amendments, AS=As Built.

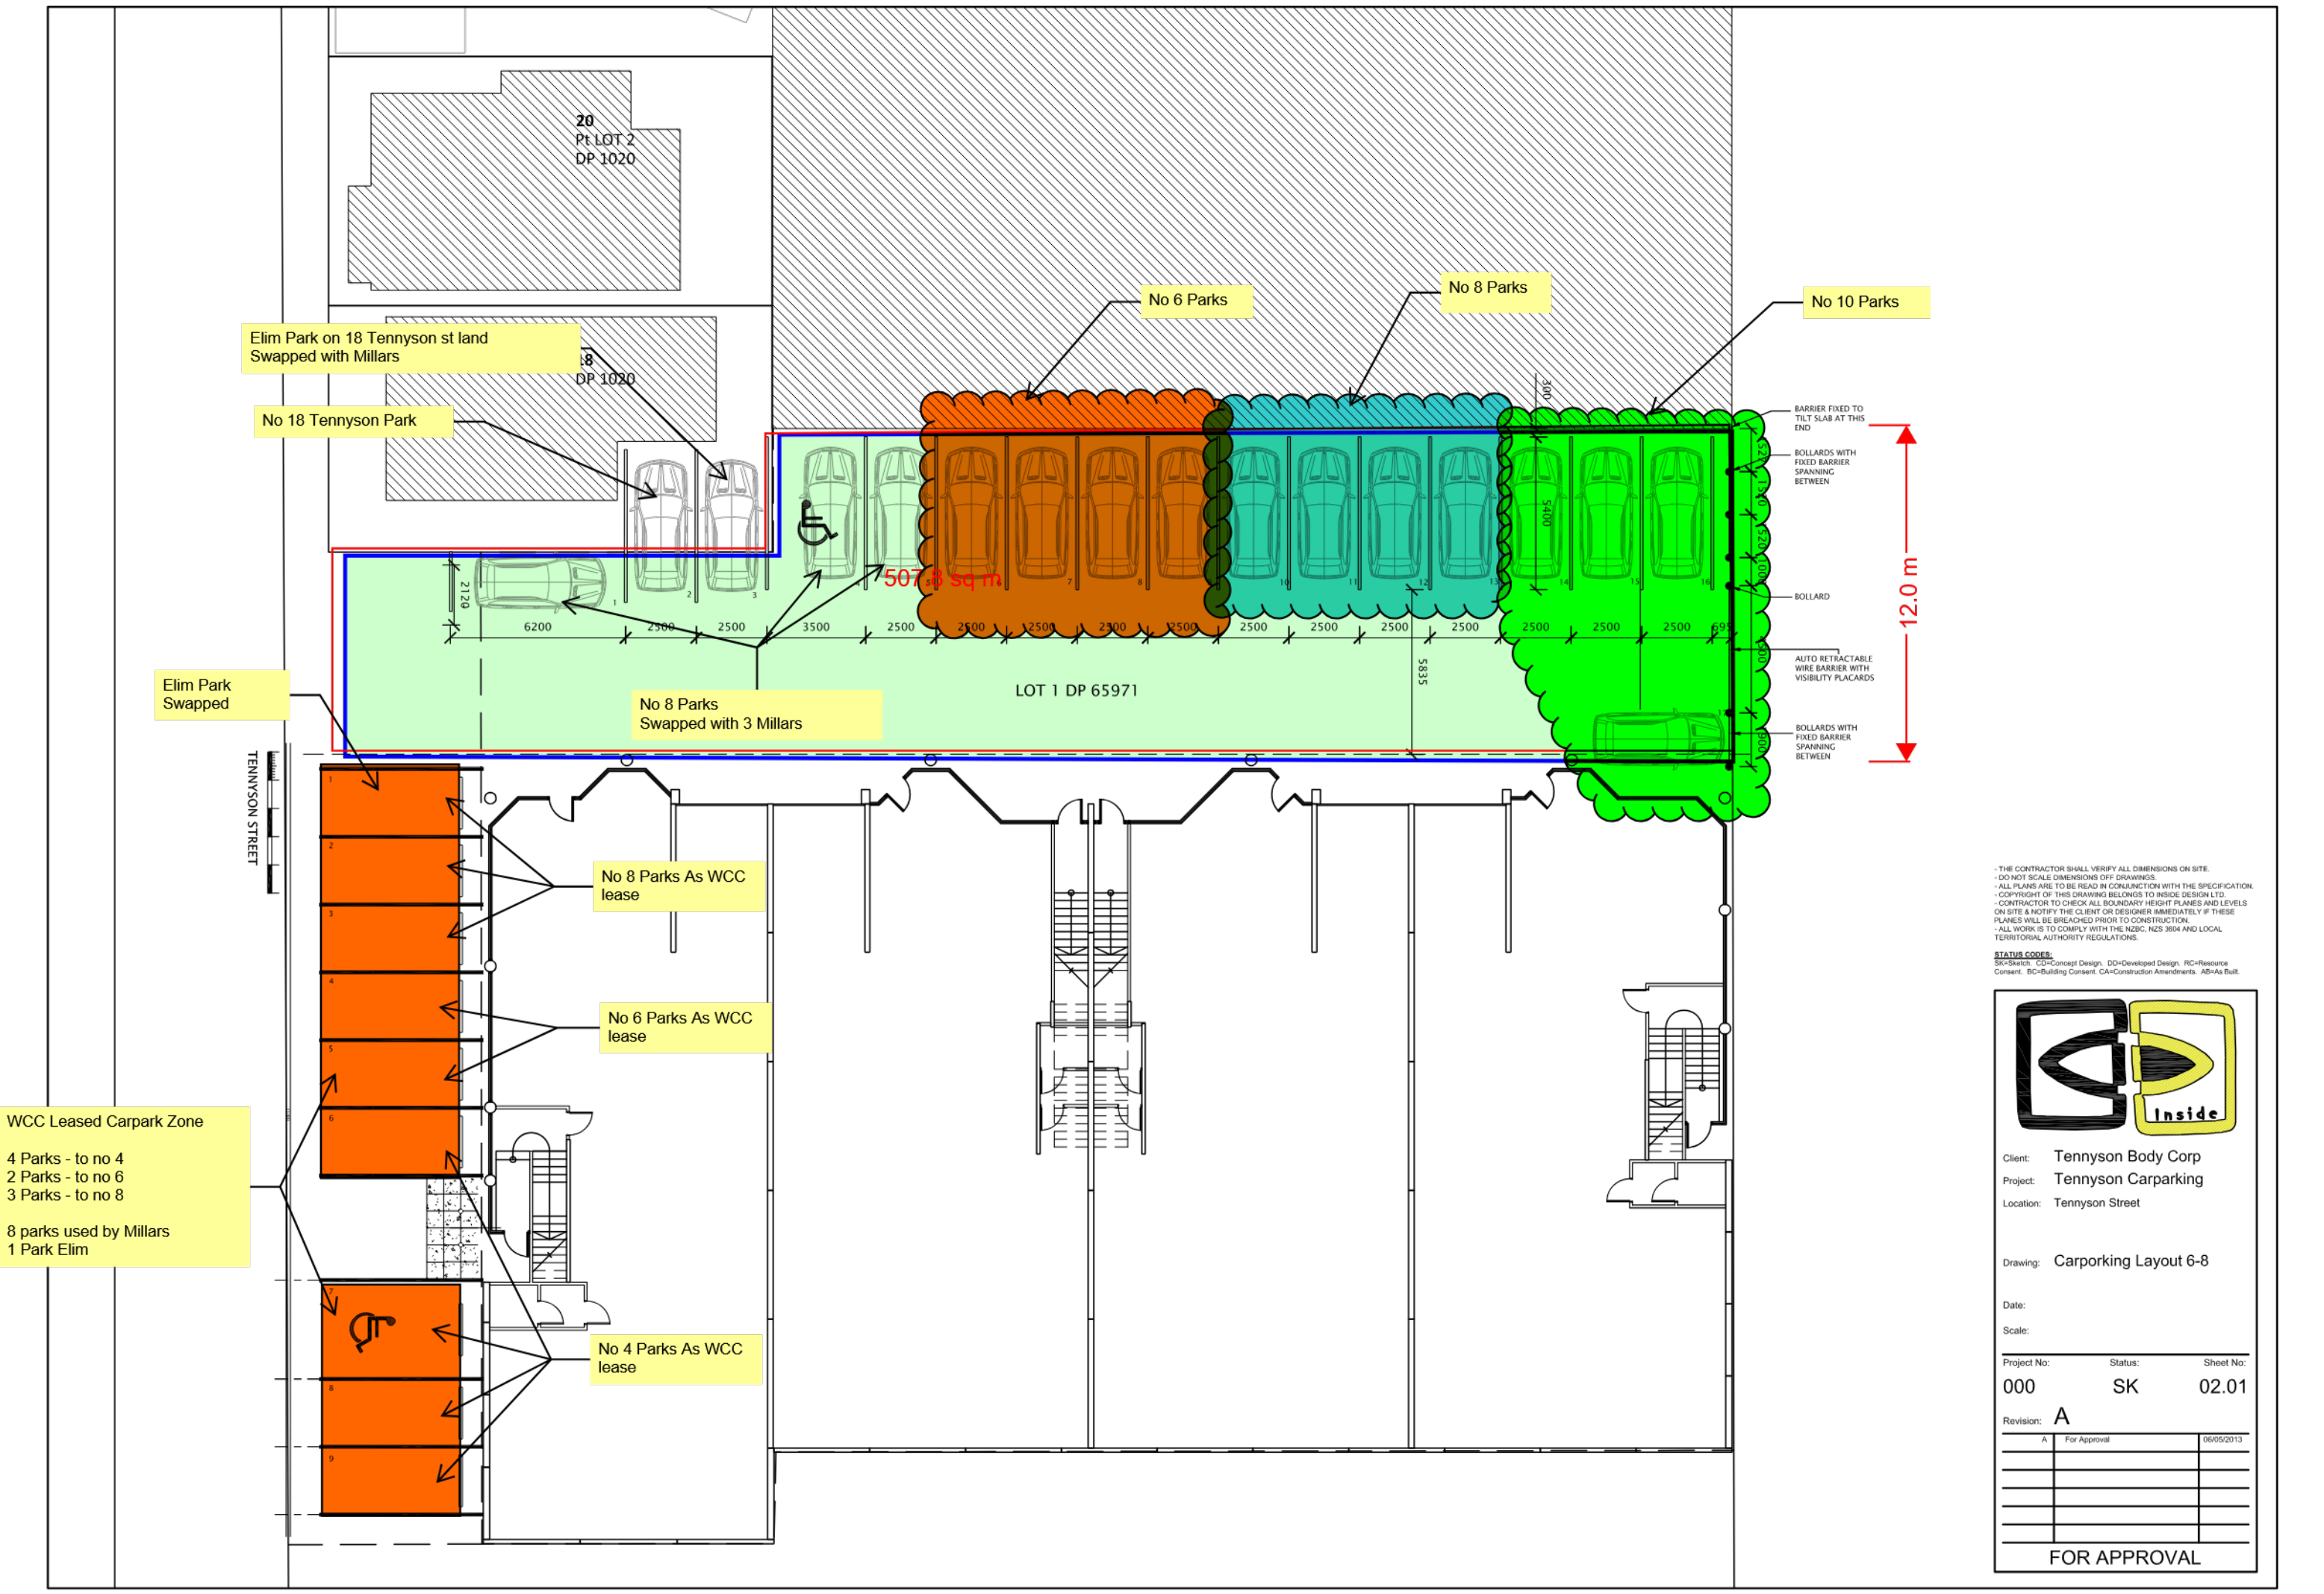

Client: Tennyson Body Corp
Project: Tennyson Carparking
Location: Tennyson Street

Drawing: Carparking Layout 6-8

Date:
Scale:

Project No: 000 Status: SK Sheet No: 02.01

Revision: A		
A	For Approval	06/05/2013

FOR APPROVAL



DISCLOSURE STATEMENT

1. The following information has been supplied to Capital Commercial (2013) Limited ("Bayleys") to be made available for distribution on the vendor's behalf to potential purchasers to assist purchasers with their due diligence and to use at the purchaser's discretion.
2. Bayleys and the Vendor do not warrant the accuracy or completeness of the information and recommends that all recipients undertake their own due diligence, obtain their own reports to their satisfaction and seek independent advice prior to committing to purchaser.