

PN513156
86 Wellington - H
Plan 99

Marlborough District Council

Job Sheet No

ASSET INSTALLATION/MAINTENANCE REPORT

ACTIVITY DETAILS

Date & Time Received...../...../.....@ .. pm/am

Response Time Mnts

Water

Sewer

S/W

NEW SERVICE


MAINTENANCE

NB: If New Service ticked fill in Parts C,D & E. If Maintenance ticked fill in Parts A,B,C & E.

PART A: LOCATION SKETCH

Type of Fault & Location (eg hydrant, valve)

LEAKING TAP

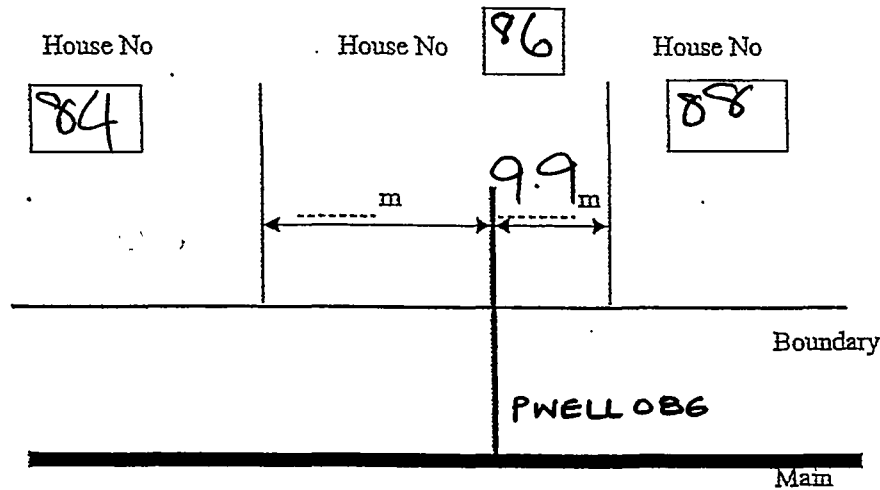

Street Name

PART B: FAULT DETAIL

Type of Failure/Problem

Water Quality	<input type="checkbox"/>
Blockage	<input type="checkbox"/>
Overflow	<input type="checkbox"/>
Leak	<input checked="" type="checkbox"/>
Low Pressure	<input type="checkbox"/>
Private	<input type="checkbox"/>
Other	<input type="checkbox"/>

Cause of Failure

Wet Weather	<input type="checkbox"/>
Ground Movt	<input type="checkbox"/>
Excavat/Thrust	<input type="checkbox"/>
Tree Roots	<input type="checkbox"/>
Pipe Deteriorate	<input type="checkbox"/>
Joint Leak	<input type="checkbox"/>
Other	<input type="checkbox"/>

If Structural, Type

Circular Fracture	<input type="checkbox"/>
Longitudinal Frac	<input type="checkbox"/>
Pipe softening	<input type="checkbox"/>
Pinhole	<input type="checkbox"/>
Large hole	<input type="checkbox"/>
Joint	<input type="checkbox"/>
Other	<input type="checkbox"/>

Maintenance/Repair Method Used

Materials/Fittings Used
1 x LXM 204

PART C: CUSTOMER INFORMATION

Customer Pre Notified Yes No

Length of time Supply Off Mnts

Number of Valves Shutdown

PART D: MAIN DETAIL

Pipe Material Surface Cover
Pipe Inside DIA mm Pipe OD mm

Bedding	Natural	Sand	Pea Metal	Scoria	Other
Joint System	Glued	Gibault	Rubber Ring	Lead	Butt
	Supertite Collar		Other	RX	

Condition Poor Moderate Very Good

PART E: SERVICE DETAIL

Service Connection For AEDEN LODGE

Nominal Dia mm Ground Cover

Notes eg further Action reqd _____

MARLBOROUGH DISTRICT COUNCIL
SEYMOUR SQUARE, PO BOX 443
BLLENHEIM, NEW ZEALAND

TELEPHONE 03 578 5249
FACSIMILE 03 578 6866



File Ref: S315-04
Prop No: 513156

Ask For: Kerry Walsh

8 June 2001

Mr Andrew Pope
5 Elmwood Street
BLLENHEIM 7301

Dear Andrew

Stormwater Realignment - Aldan Lodge, Wellington Street, Picton

Further to your request to alter the alignment of the stormwater main which runs through the property your client wishes to develop in Wellington Street, Picton.

Council has no problems with this request and will contribute 50% of costs for construction design and installation provided that:

- A registered engineer is engaged to produce construction design and drawings.
- Council view and accept prices submitted by tenders before commencement of construction.
- That only Council approved contractors, who must have the required health and safety plans in place be employed.
- All work is to be supervised by an engineer or his/her representative.
- As built plans are submitted to Council at the completion of the work.

Yours sincerely

**KERRY WALSH
ENGINEERING OFFICER**

