
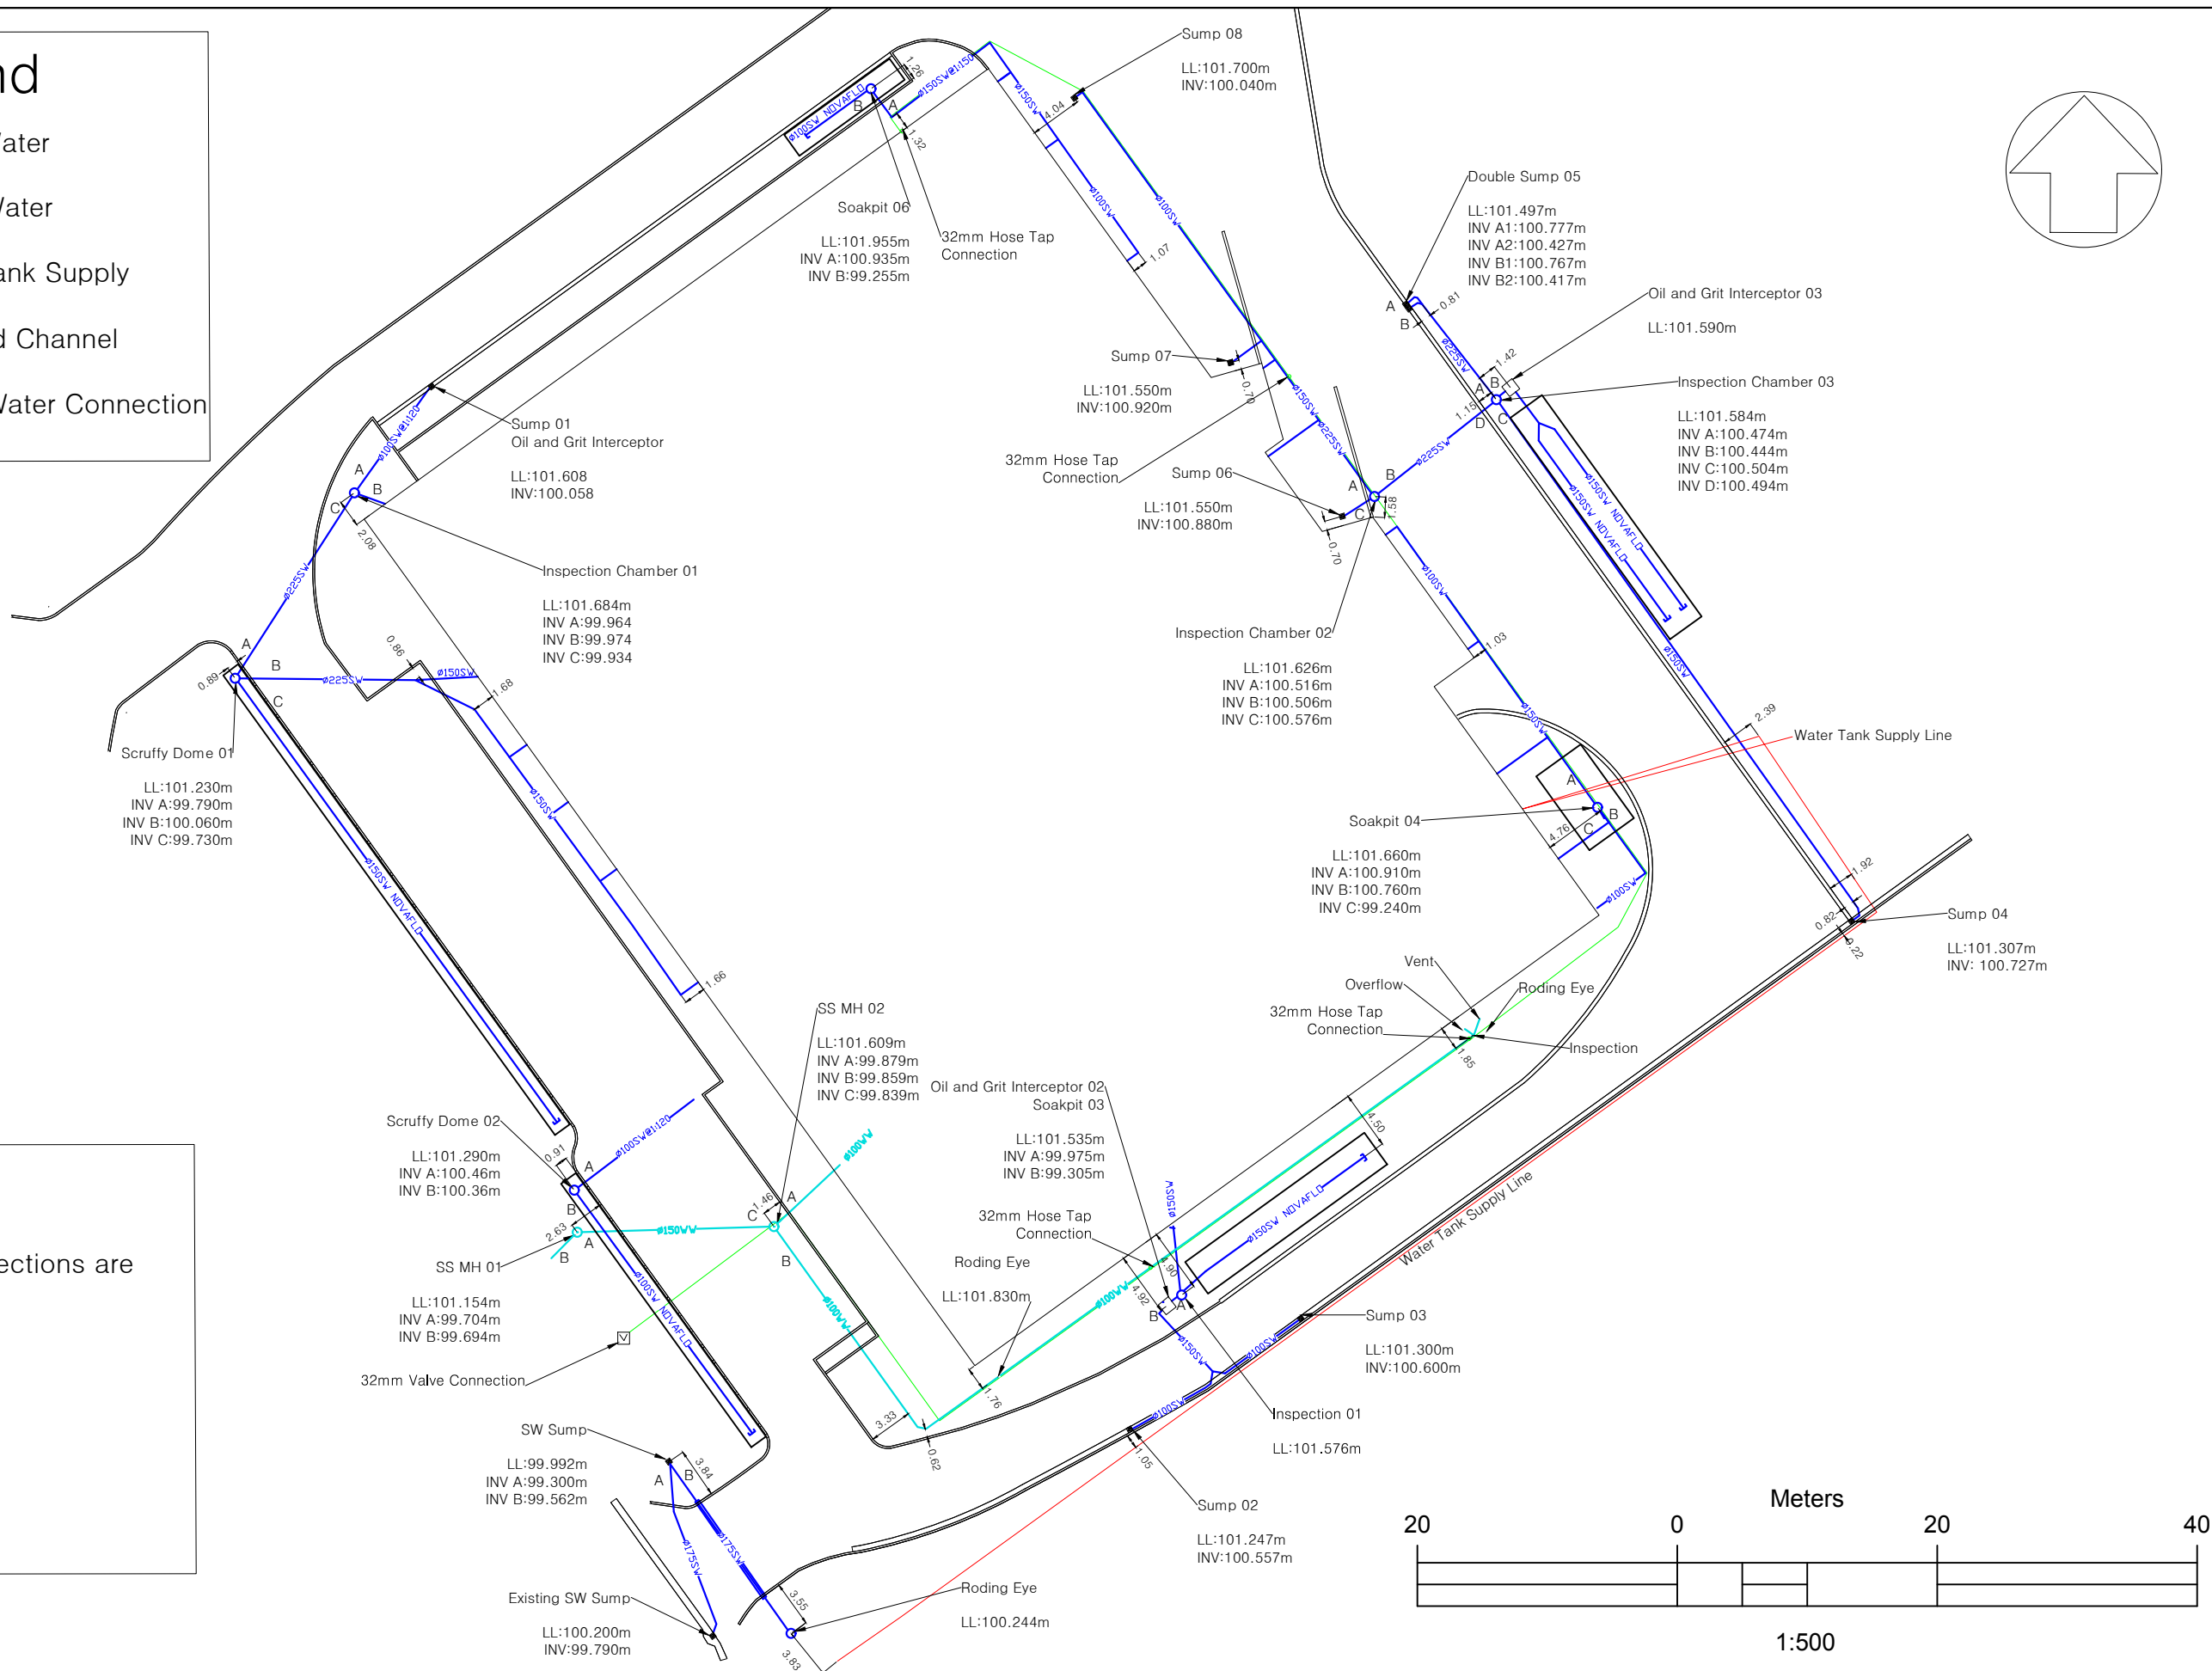


Legend

- Storm Water
- Waste Water
- Water Tank Supply
- Kerb and Channel
- 32mm Water Connection

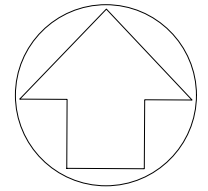

Notes

All Down Pipe Connections are 150mm

DESIGN: NZ Dairy Asbuild	SURVEYED: F.Pichon
APPROVAL:	DRAWN: F.Pichon DATE: 23/08/16
CHECKED:	
SCALE: 1:500 (A3)	DWG NO: 1
ALL DIMENSIONS ARE IN m	

NZ Dairy SW & WW Asbuild



REV	PAGE
1	A